



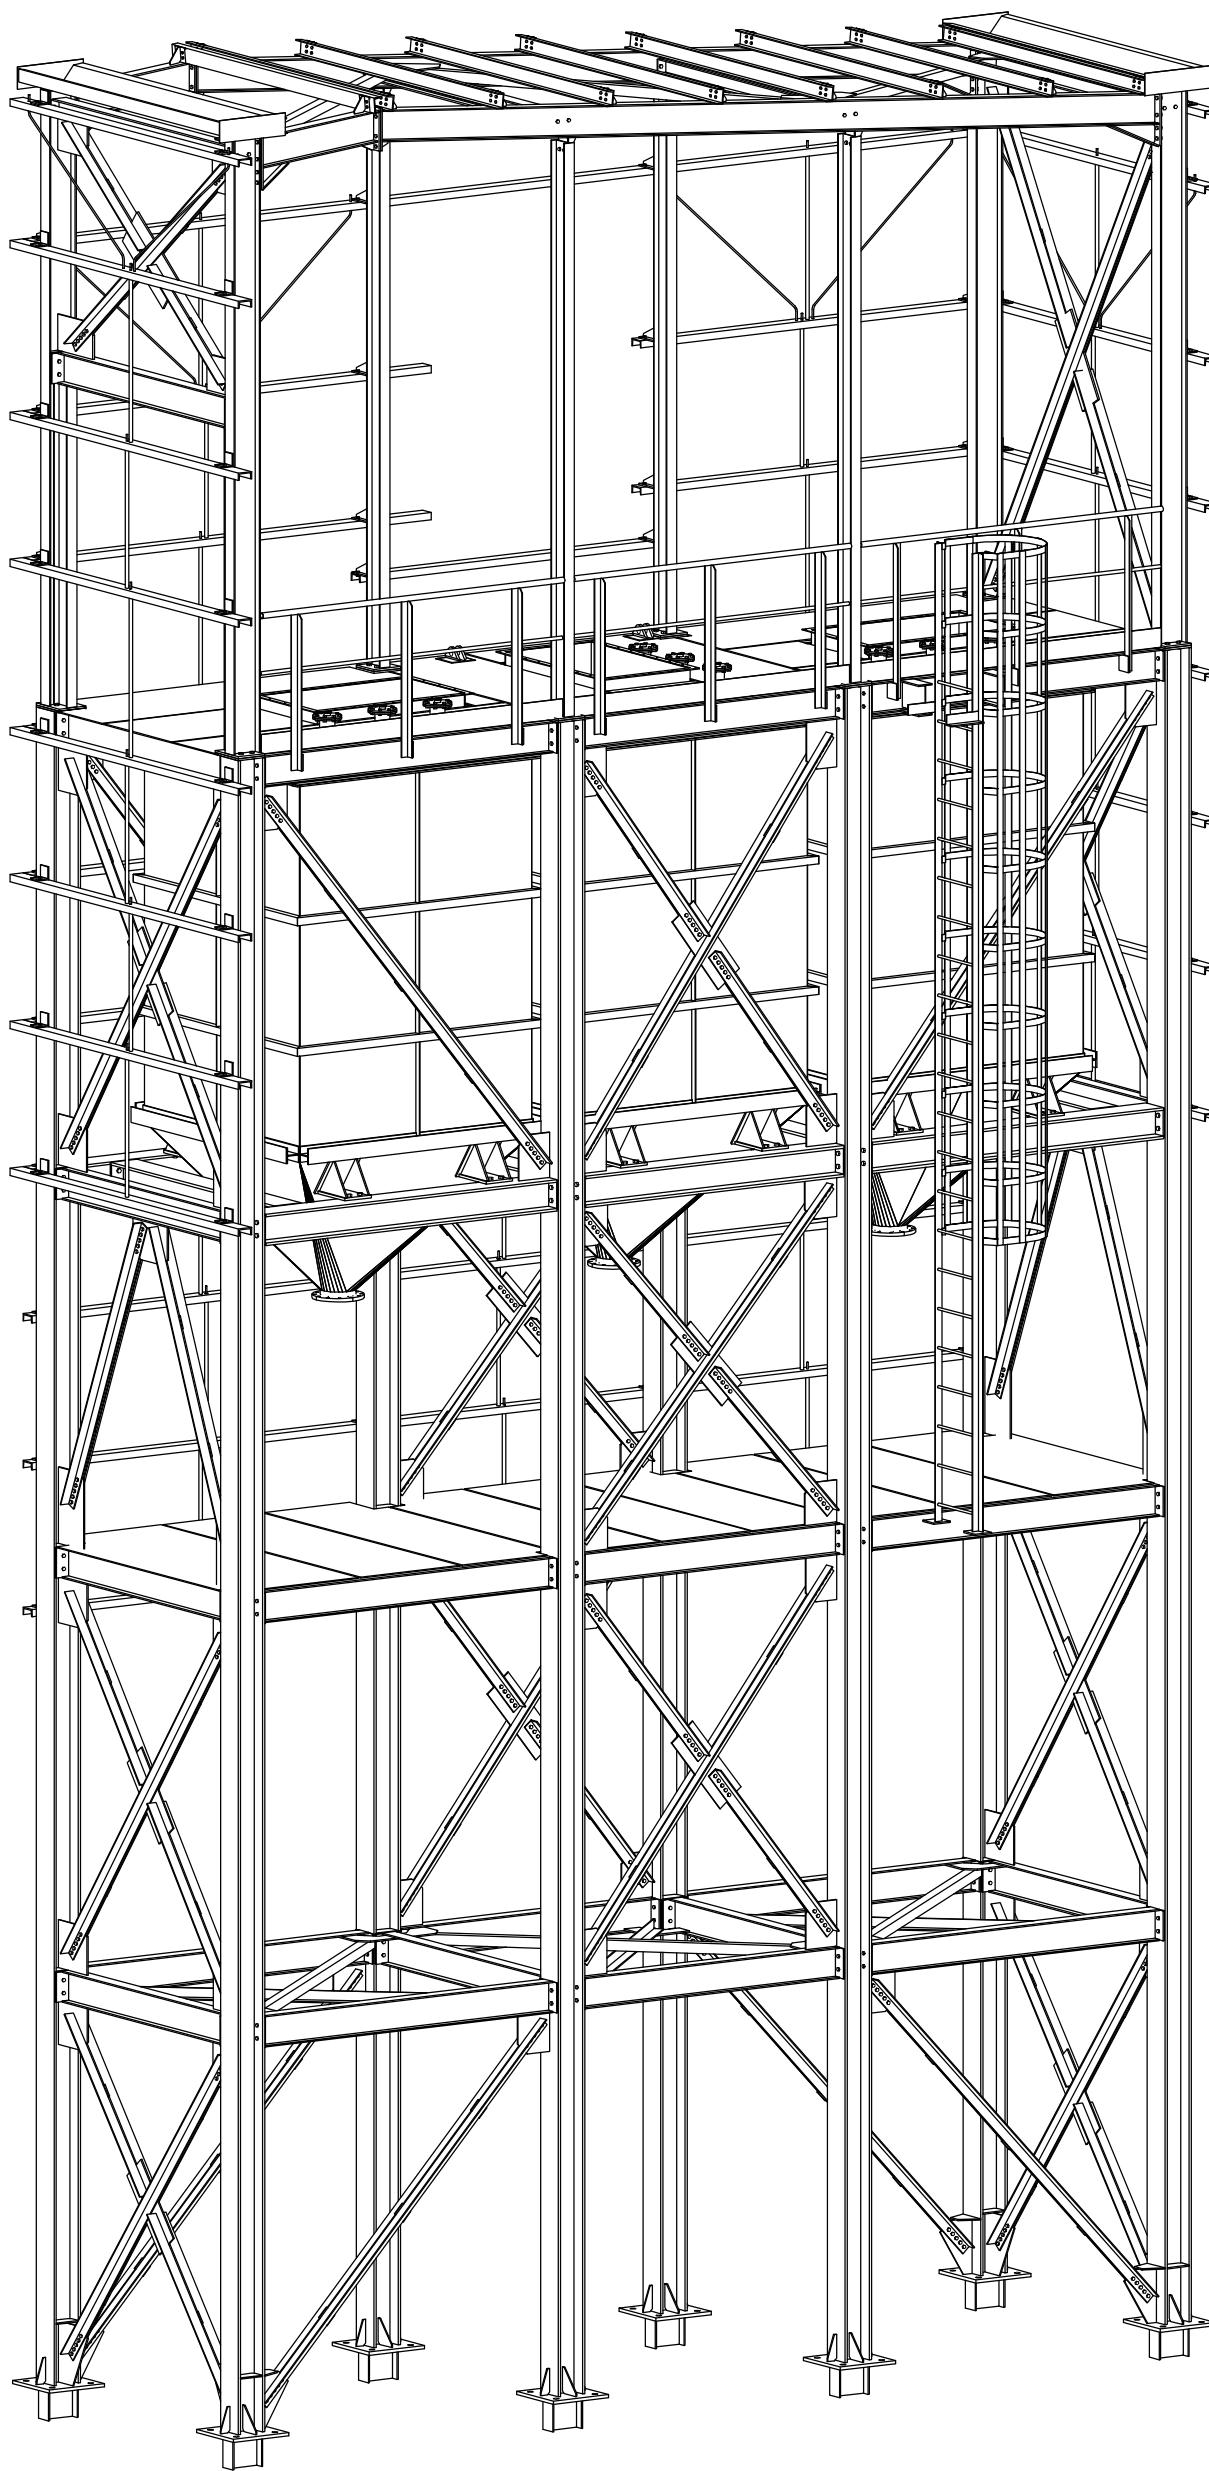

3d

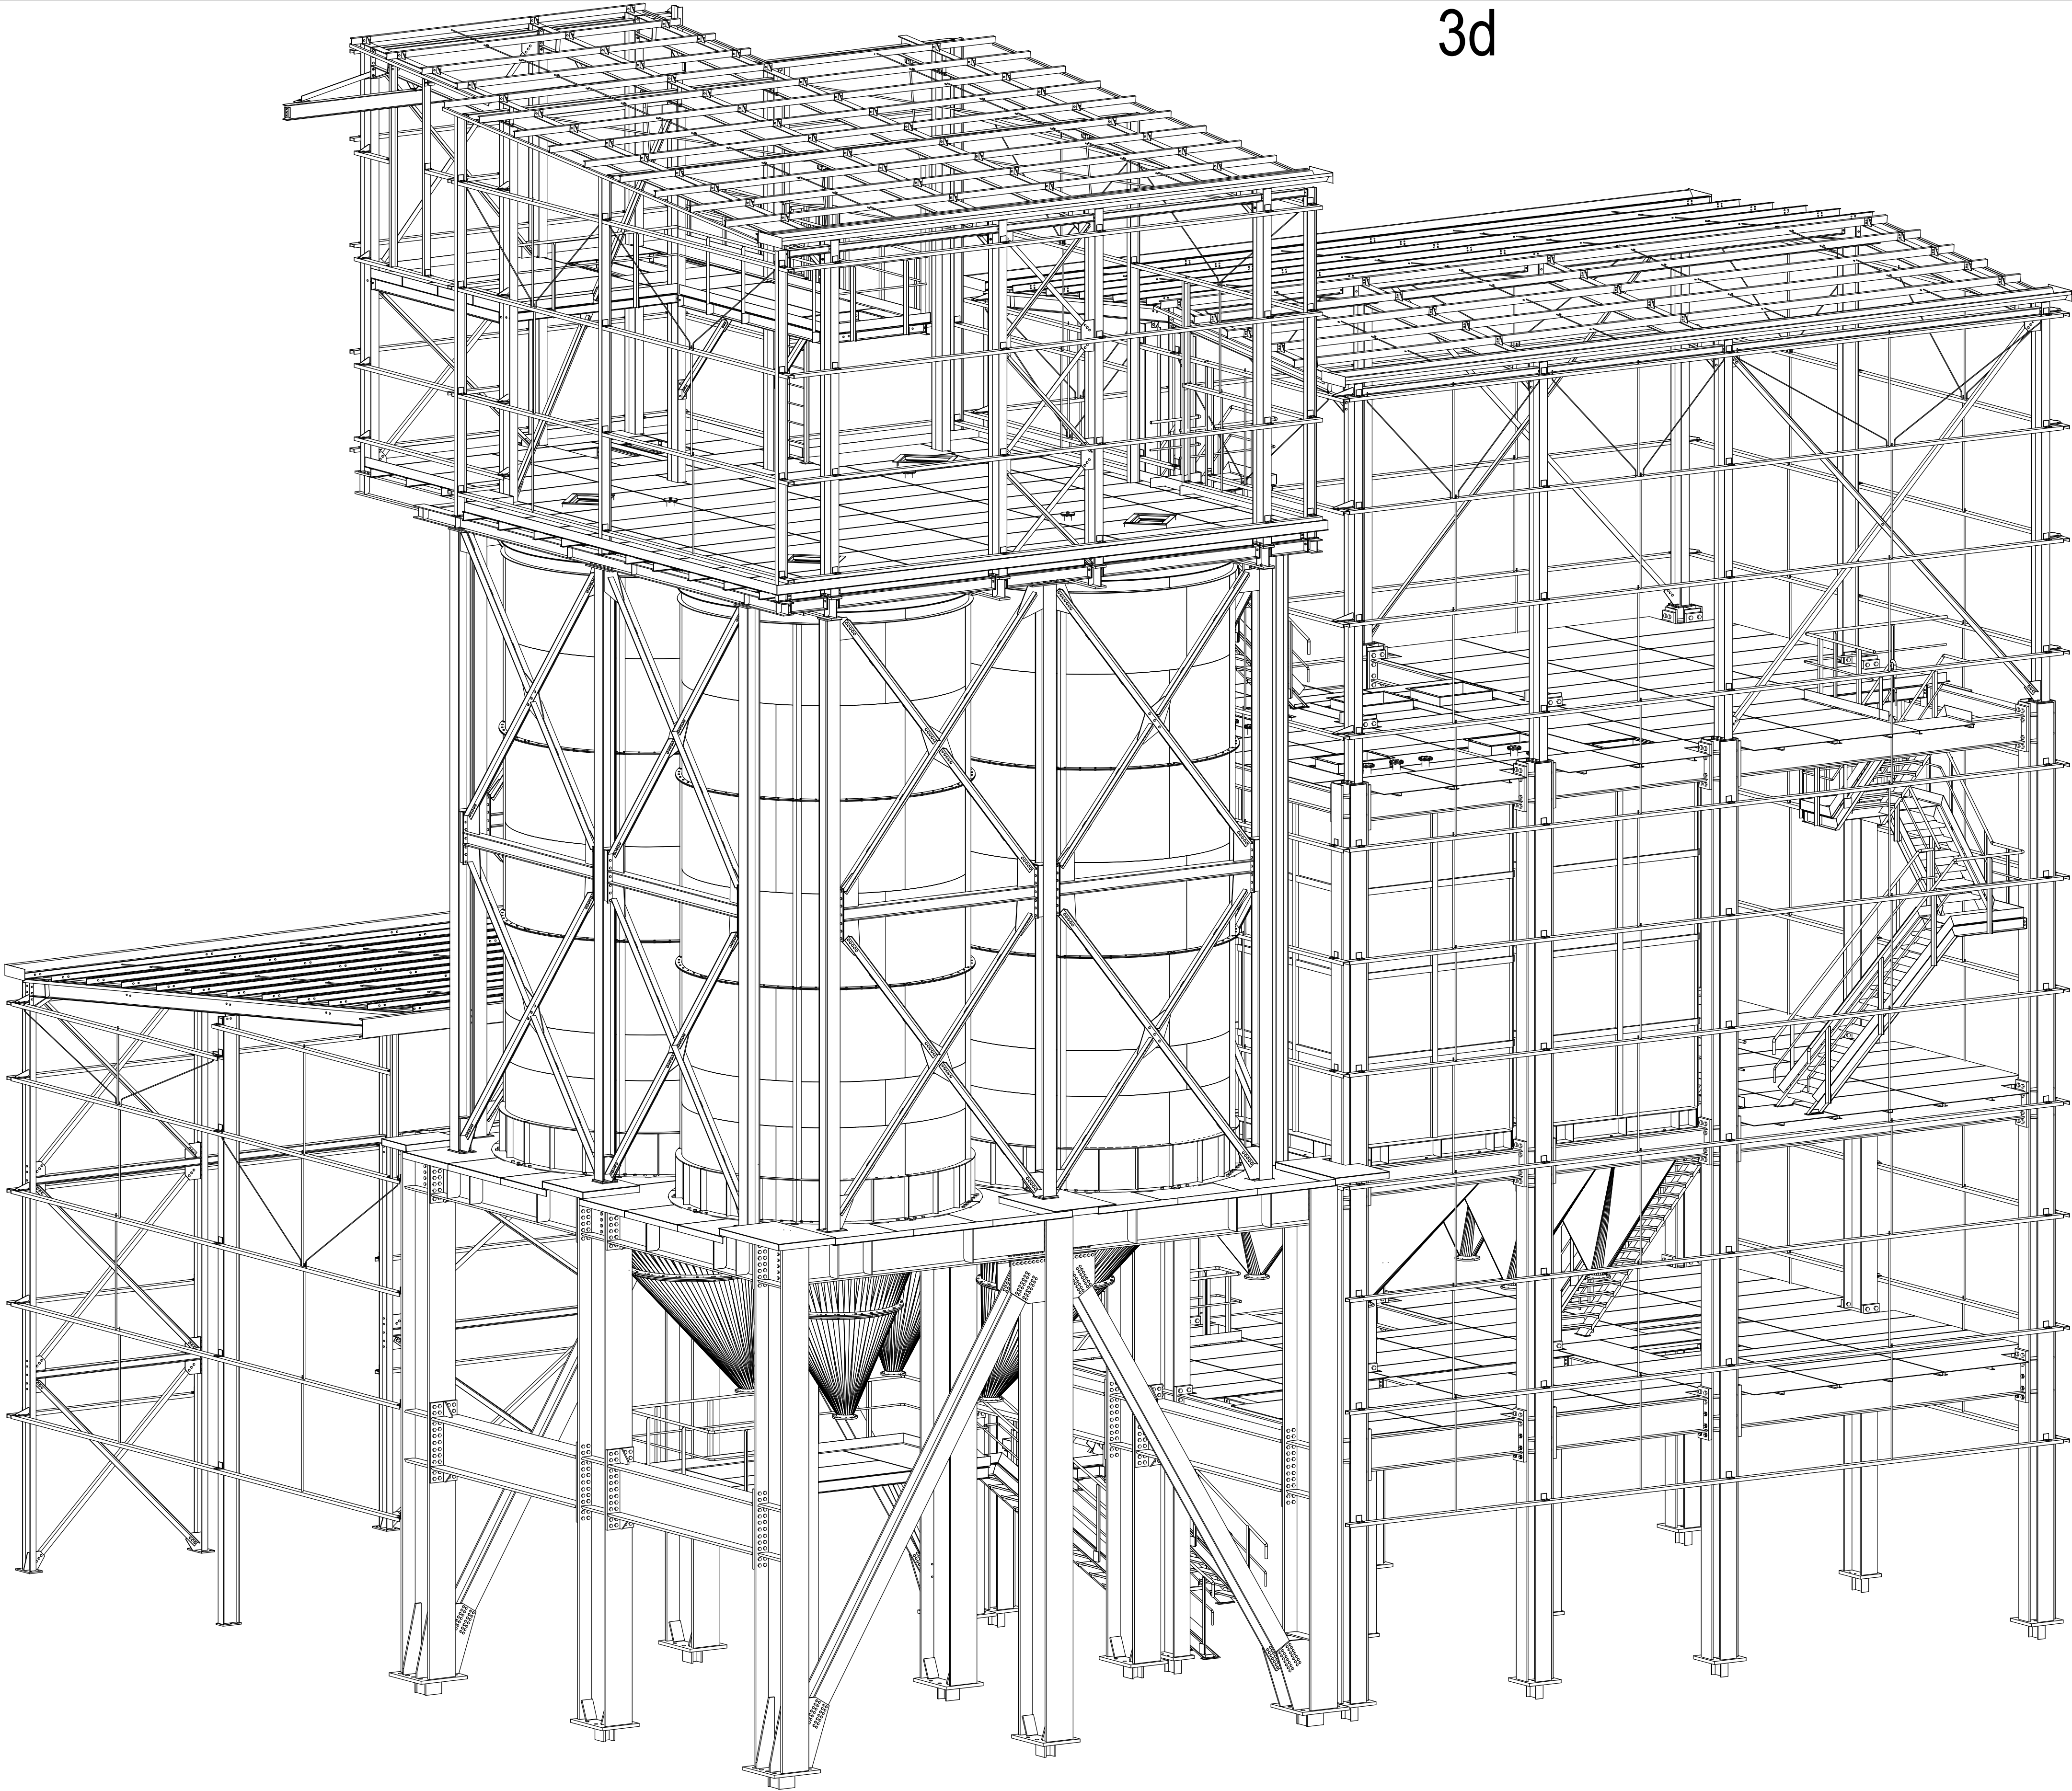

Asbuilt	1400/12/07	ISSUED FOR CONSTRUCTION	M.Safae	Amini	Tahmasebi
Rev.	Date	DESCRIPTION	Prepared	Checked	Approved
Client		DESCRIPTION :	Contractor		
 GLASS WOOL COMPANY OF IRAN		STEEL STRUCTURE OF SILOS & TRUCK UNLOADING STRUCTURE	 EPCESCO.		
		Drawing Title: GLASS WOOL PRODUCTION LINE TRANSFER			
File No. : GWP20005C301001-2		Size: A1	Scale:1/80 N.T.		